


SEPTIC SYSTEM AS-BUILT

16 CROOKED MEADOW LANE

HINGHAM, MASSACHUSETTS


ELEVATIONS

TOP OF FOUNDATION	=36.33
BLDG OUT	=33.78
SEPTIC TANK IN	=33.06
SEPTIC TANK OUT	=32.85
D-BOX IN	=32.80
D-BOX OUT	=32.63
TOP OF CHAMBER	=32.74

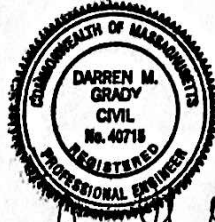

Darren Grady

INSTALLER:
E.L. MARGETTS & SONS, INC.
97 WARD STREET
HINGHAM, MA 02043

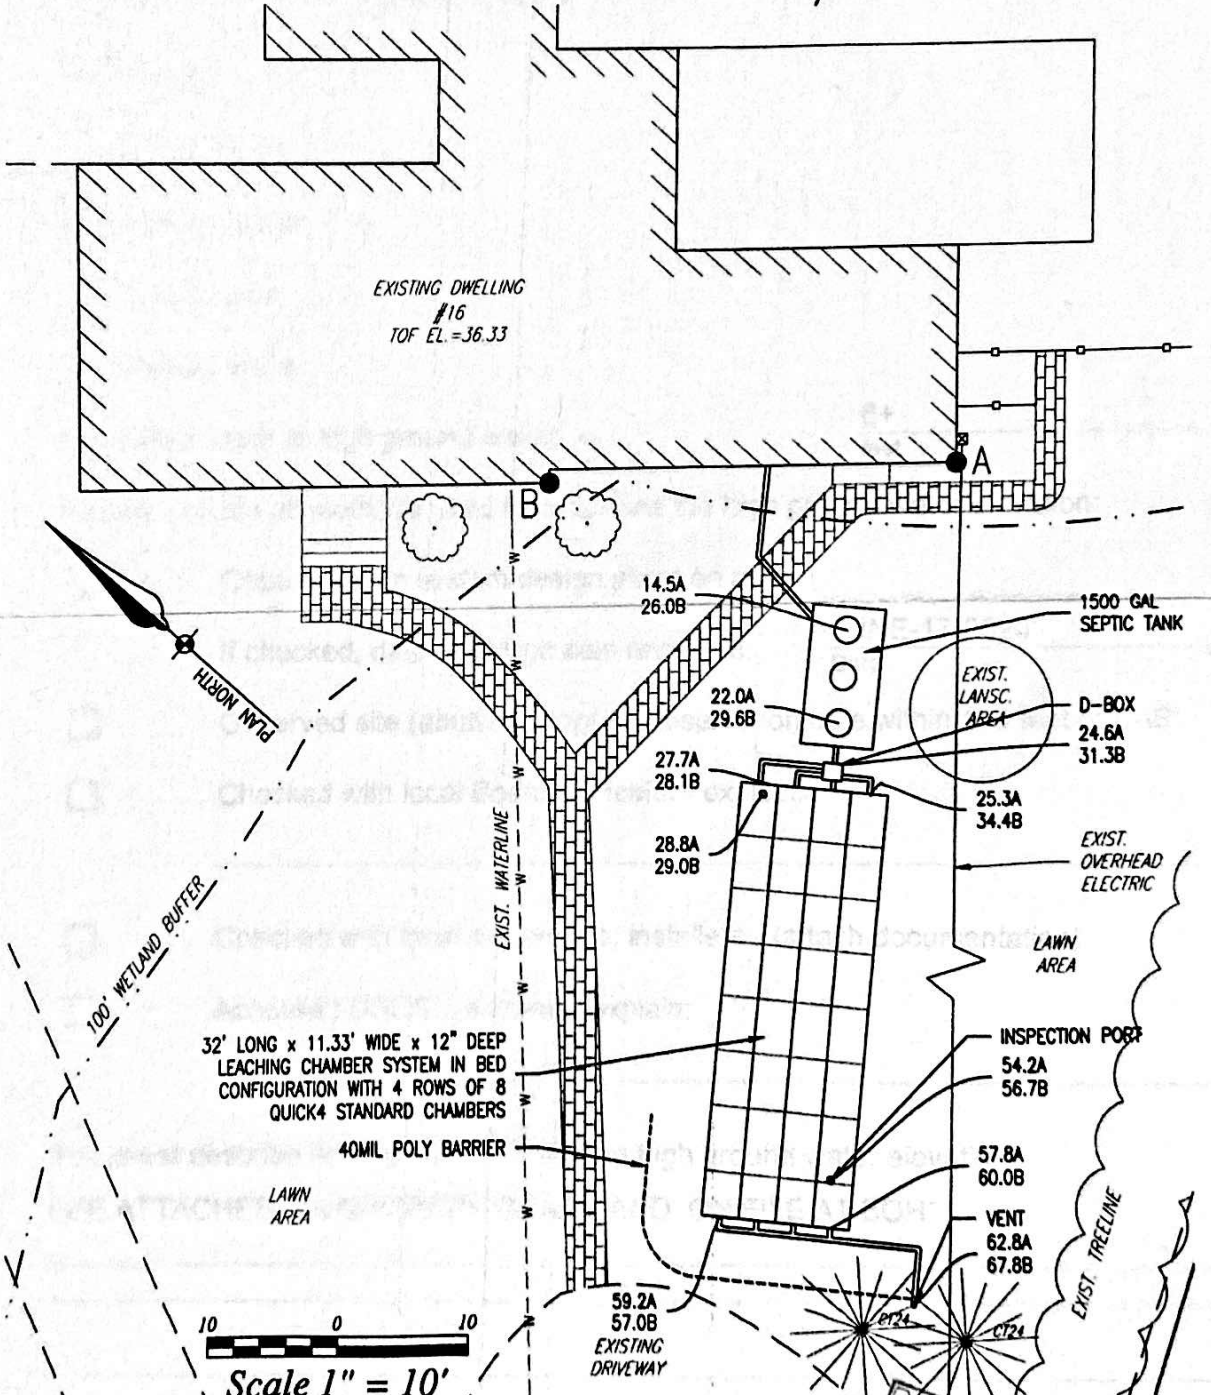

GRADY CONSULTING, L.L.C.

◆ Civil Engineers Land Surveyors & Landscape Architects ◆

Applicant/Owner
WILLIAM & ELLEN ROE
16 CROOKED MEADOW LANE
HINGHAM, MA 02043

71 EVERGREEN STREET - KINGSTON, MA 02364
Tel. (781)585-2300 - Fax. (781) 585-2378

RECEIVED
AUG 27 2020
AUGUST 21, 2020
SCALE: 1" = 10'
JOB NO. 20-181