


52x121

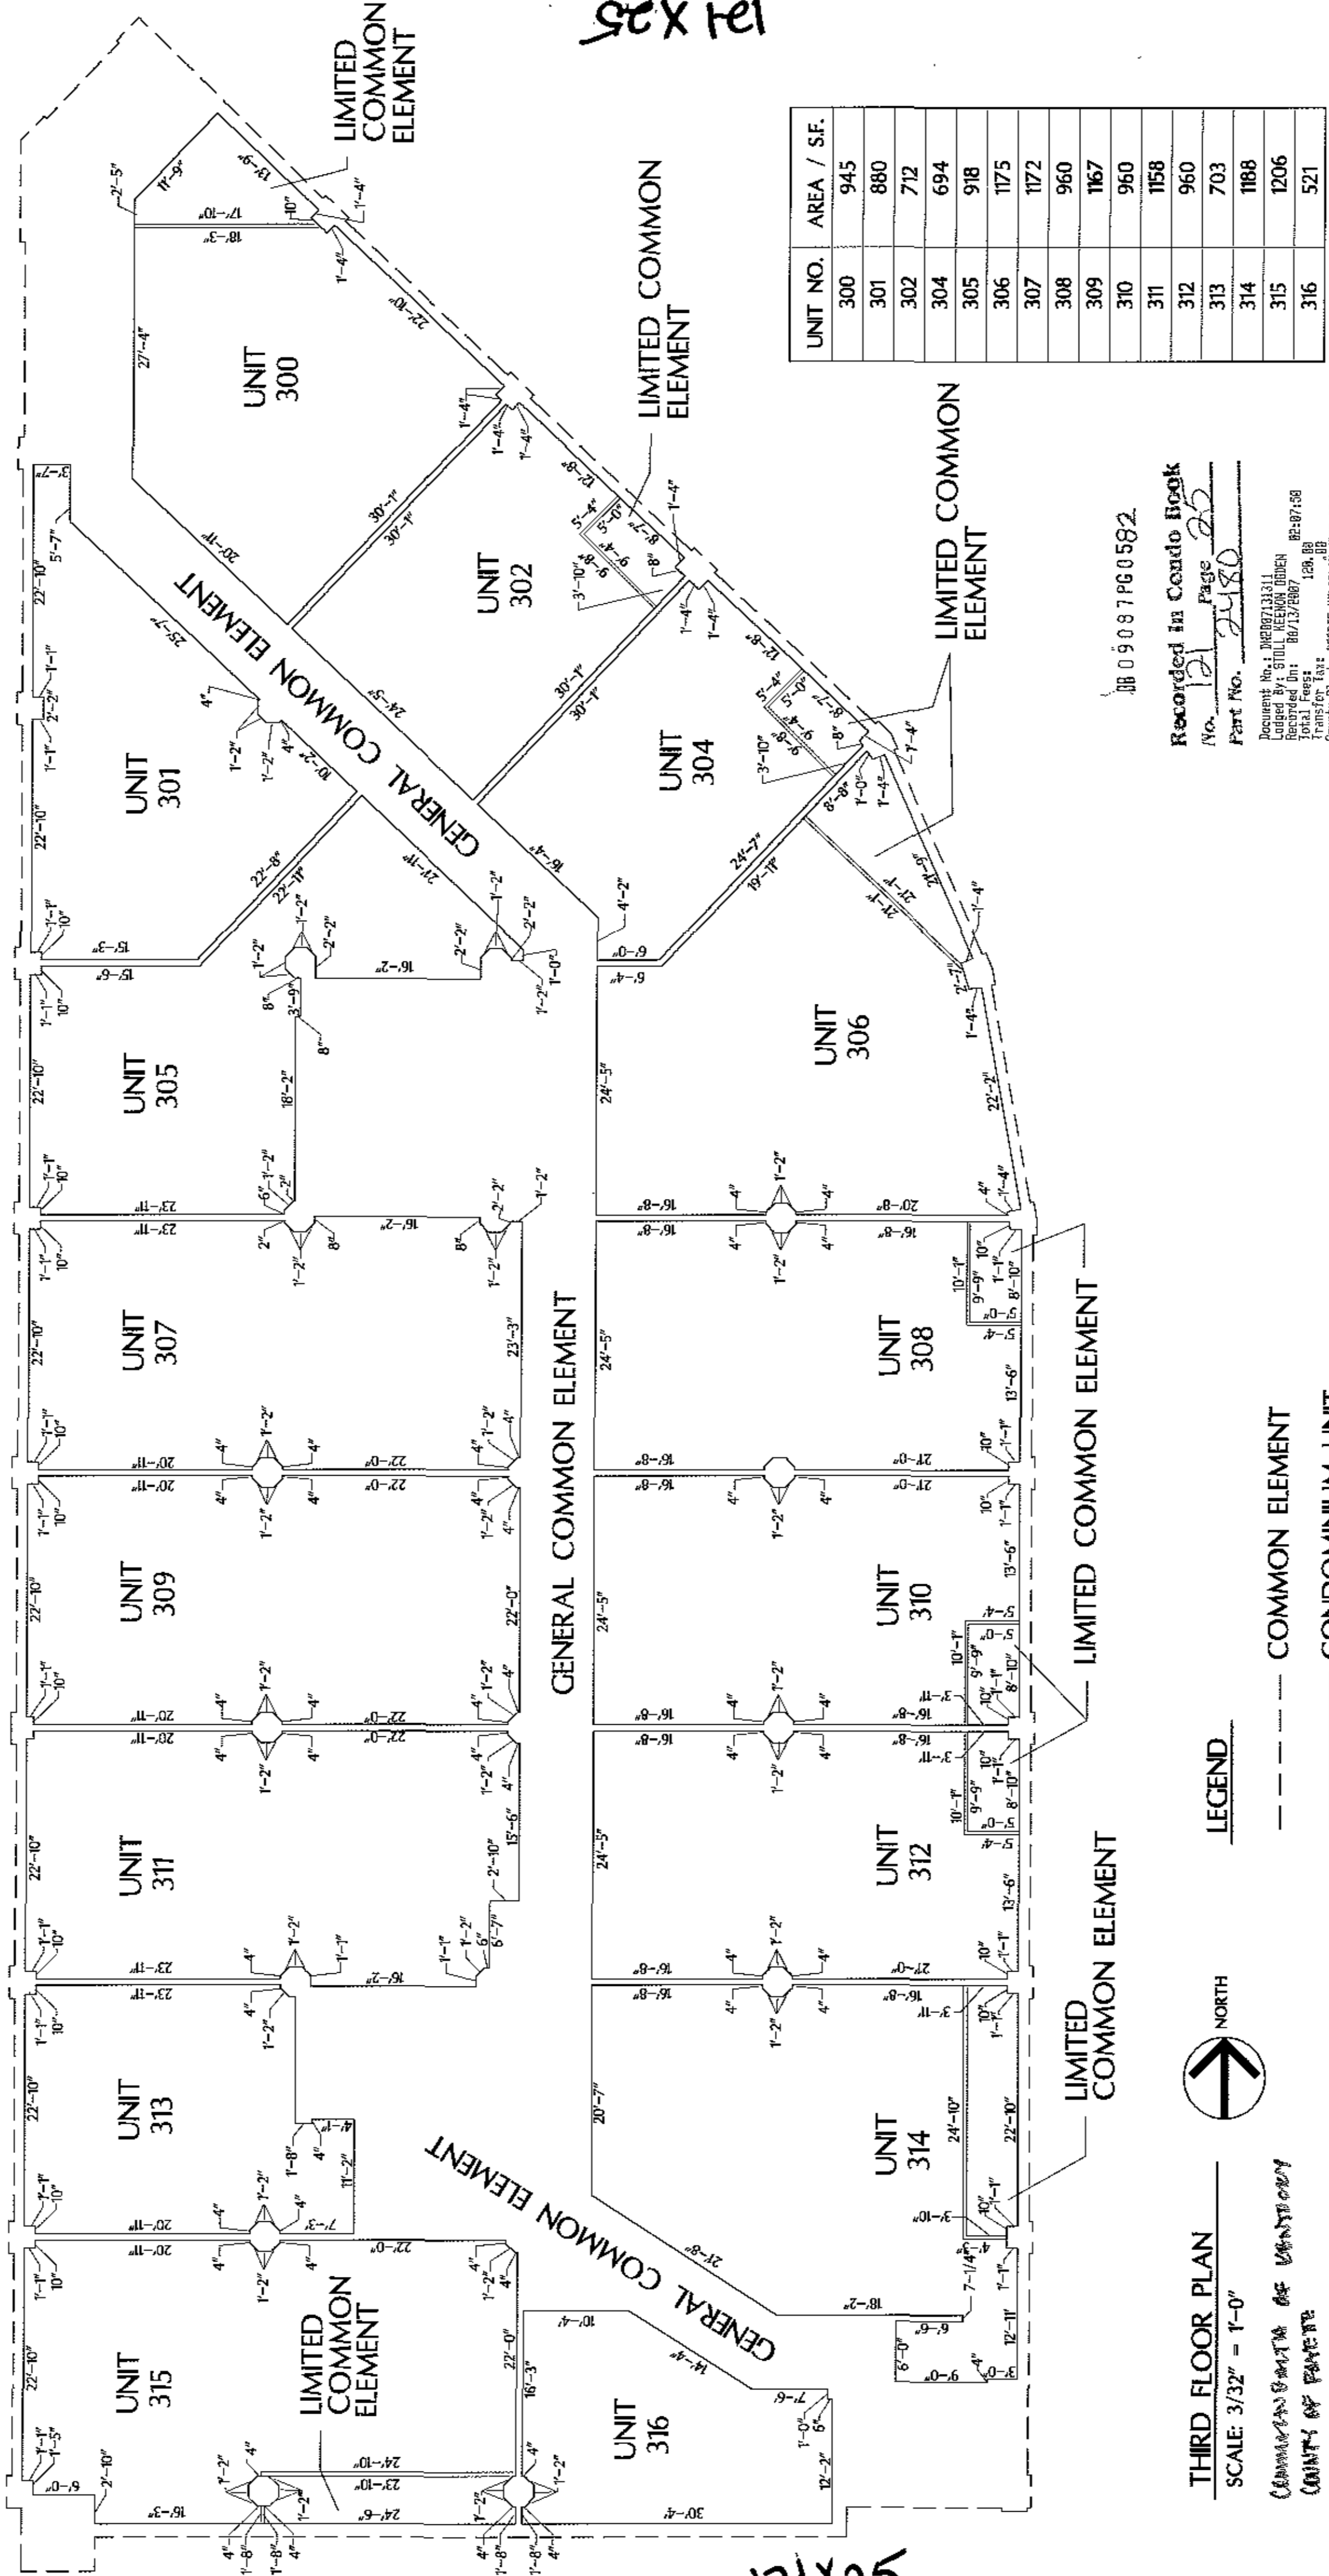

UNIT NO.	AREA / S.F.
300	945
301	880
302	712
304	694
305	918
306	1175
307	1172
308	960
309	1167
310	960
311	1158
312	960
313	703
314	1188
315	1206
316	521

JOB 09097 PG 0582

Recorded in Condo Book
 No. 121 Page 22
 Part No. 2480

Document No.: DP00731311
 Lodged By: STULL, ALEXANDER (DBEN)
 Recorded On: 06/13/2007 RE-897-80
 Total Fees: 128.00
 County Clerk: HERRICK, MICHAEL JEFF CO KY
 Deputy Clerk: TERRILL



THIRD FLOOR PLAN
 SCALE: 3/32" = 1'-0"

COMMERCIAL REAL ESTATE
 COMPANY OF KENTUCKY
 SUBJECT: 2520 THIRD STREET, LOUISVILLE, KY 40202
 JULY 24, 2007 BY MICHAEL V. KRAHL
 MICHAEL V. KRAHL
 KY COMMISSIONER EXPIRES: 6-14-2009

LEGEND
 --- COMMON ELEMENT
 --- CONDOMINIUM UNIT



I hereby certify that the plans fully and accurately depict the layout, location, unit numbers and dimensions of the units as built.

Signature: *Michael V. Krahl*
 Date: 7-24-07

The McGoodwin Company
 Commercial Real Estate

REYNOLDS LOFTS CONDOMINIUMS
 2520 THIRD STREET
 LOUISVILLE, KENTUCKY
 JULY 18, 2007

52x121

