


125 x 27

125 x 27

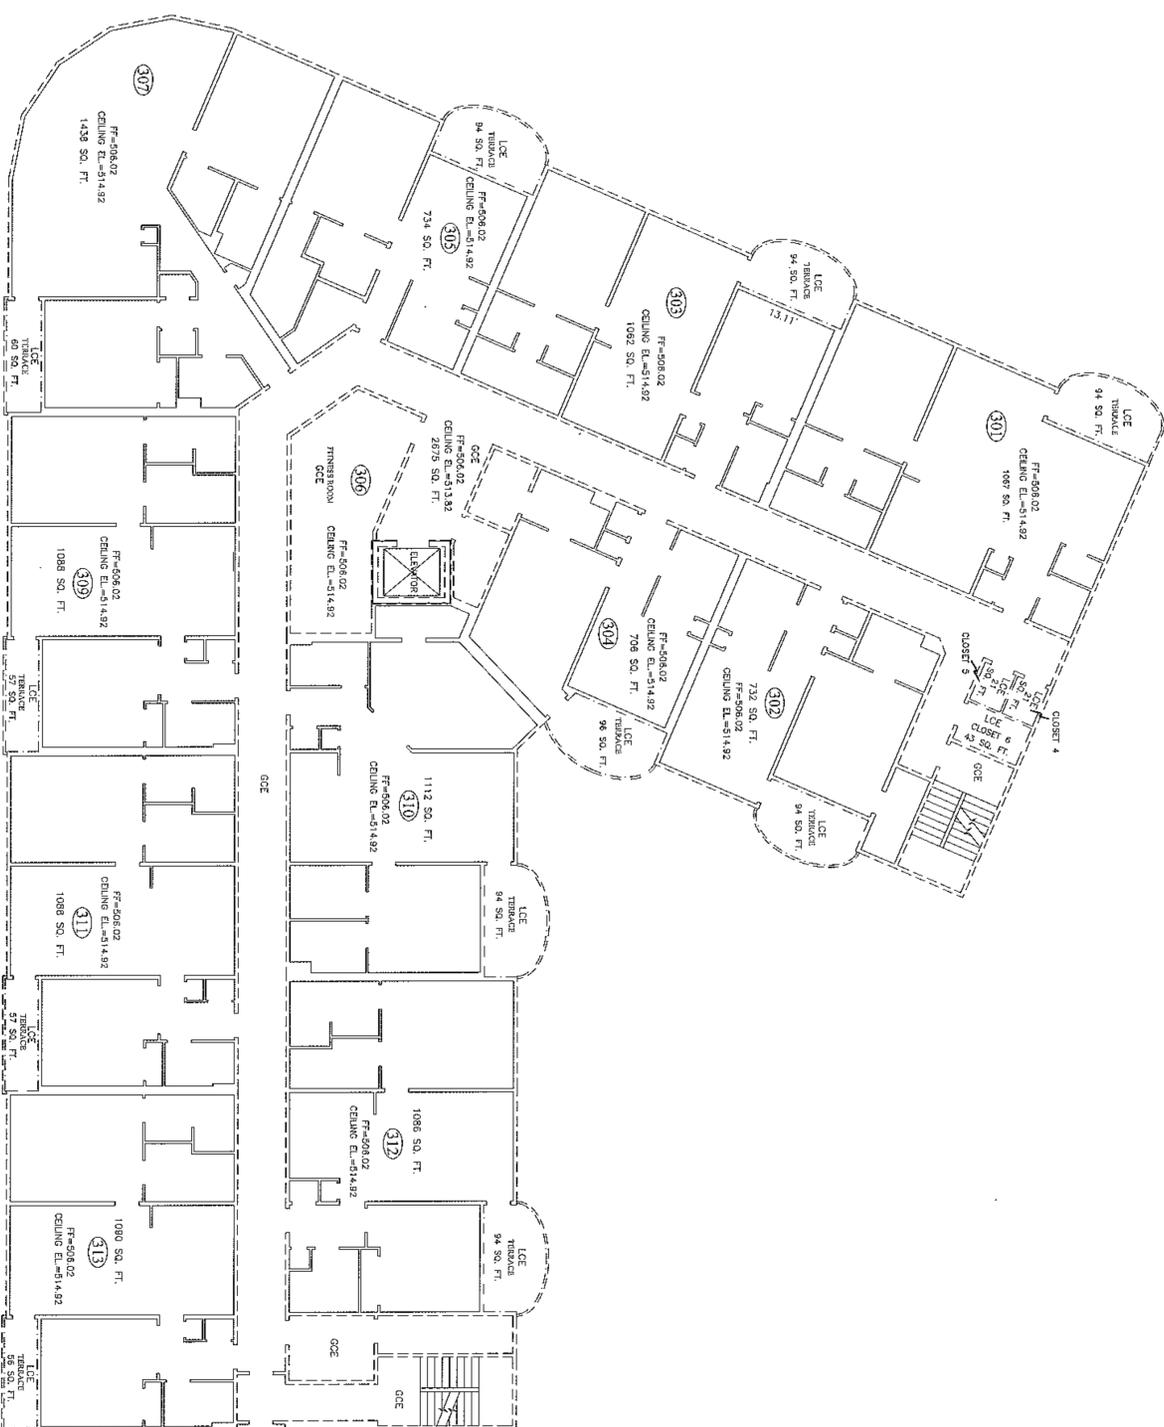

THIRD FLOOR

LEGEND

- BOUNDARY OF CONDOMINIUM UNITS
- - - - - INDICATES LIMITED COMMON ELEMENTS (LCE)
- INDICATES GENERAL COMMON ELEMENTS (GCE)
- - - - - INDICATES LINE WHERE ELEVATION CHANGE OCCURS



GRAPHIC SCALE

Recorded In Condo Book
 No. 125
 Part No. 27

09271 PG. 093

CLIFF VIEW TERRACE CONDOMINIUM REGIME

SURVEYOR'S CERTIFICATE

I HEREBY CERTIFY THAT THE SURVEY FOR THIS PLAT FOR BUILDINGS WAS MADE UNDER MY SUPERVISION AND THAT THE ANGULAR AND LINEAR MEASUREMENTS AND THE VERTICAL ELEVATIONS SHOWN HEREON WERE ESTABLISHED FROM RECORDS AND EXISTING MONUMENTS FOUND IN THE FIELD, AND ARE TRUE AND CORRECT TO THE BEST OF MY KNOWLEDGE AND BELIEF. THIS SURVEY MEETS OR EXCEEDS THE MINIMUM STANDARDS OF GOVERNING AUTHORITIES.

I FURTHER CERTIFY THAT THIS IS A TRUE AND ACCURATE COPY OF THE DRAWINGS AND PLANS OF THE BLDG AT 2411 BROWNSBORO RD. PROJECT SHOWING THE LAYOUT, LOCATION, SUITE NUMBER AND DIMENSIONS OF THE UNIT. THESE PLANS FULLY AND ACCURATELY DEPICT THE LAYOUT, LOCATION AND DIMENSION OF THE UNITS AS BUILT.

Robert M. ...
 LICENSED PROFESSIONAL SURVEYOR
 DATE 7-15-08

JOB NO. 00000
 SHEET 3 OF 4

AS-BUILT SURVEY CLIFF VIEW TERRACE, 2411 BROWNSBORO ROAD
CLIFF VIEW TERRACE LLC
 ROGERS STREET FIREHOUSE
 1122 ROGERS STREET
 LOUISVILLE, KY 40204

CARDINAL SURVEYING SERVICES, INC.
 9009 PRESTON HWY
 LOUISVILLE, KY 40219
 (502) 966-3446
 FAX: (502) 968-7077
 cardsurvey@insightbb.com

PROJECT DATA
 FILE NAME: CLIFF VIEW TERRACE
 DATE: 06-21-07
 SCALE: 1" = 10'
 DRAWN BY: TY




REVISIONS			BY
NO.	DATE	DESCRIPTION	TY
1	2/29/08	REVISED CLOSETS	

125 x 27

125 x 28


- LEGEND**
- BOUNDARY OF CONDOMINIUM UNITS
 - - - INDICATES LIMITED COMMON ELEMENTS (LCE)
 - INDICATES GENERAL COMMON ELEMENTS (GCE)
 - INDICATES LINE WHERE ELEVATION CHANGE OCCURS

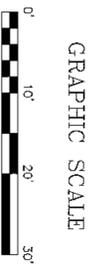

Document No.: 092711PG-1093
 Title: CLIFF VIEW TERRACE CONDOMINIUM REGIME
 Date: 07/15/08
 Drawing Date: 07/15/08
 County: Shelby
 Project: CLIFF VIEW TERRACE
 Designer: JAMES BROWN
 Checker: ROBERT HUSTON
 Title: ARCHITECT

092711PG-1093

FOURTH FLOOR

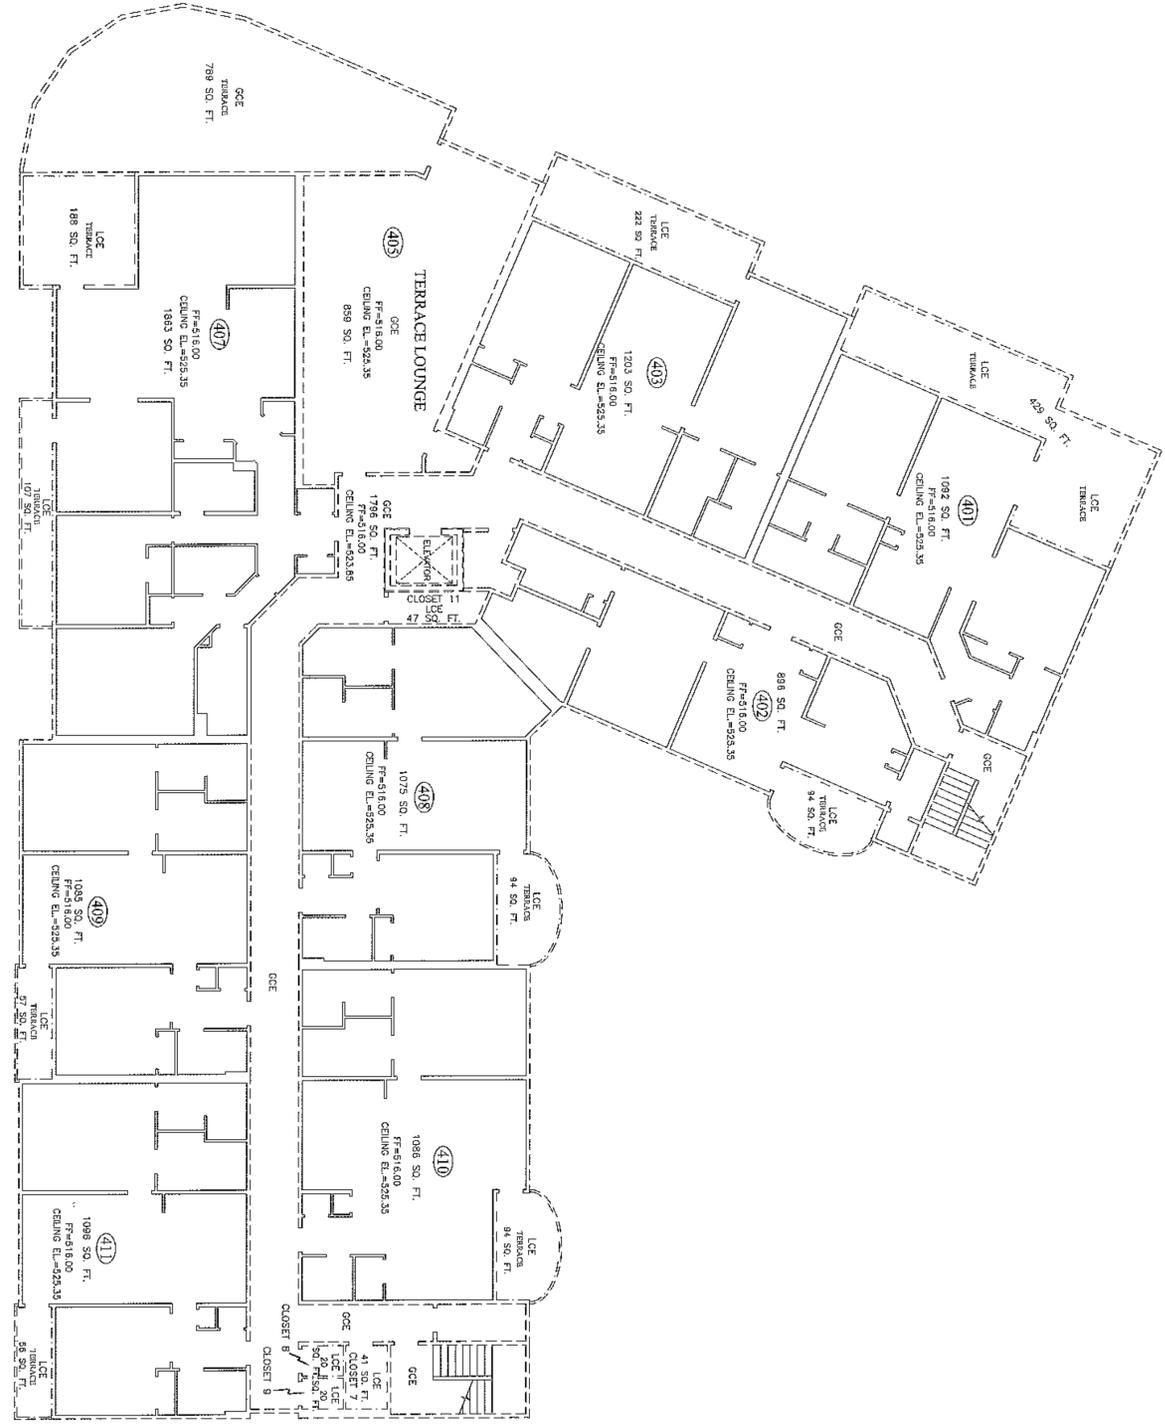

125 x 501

CLIFF VIEW TERRACE CONDOMINIUM REGIME

SURVEYOR'S CERTIFICATE

I HEREBY CERTIFY THAT THE SURVEY FOR THIS PLAT FOR BUILDINGS WAS MADE UNDER MY SUPERVISION AND THAT THE ANGULAR AND LINEAR MEASUREMENTS AND THE VERTICAL ELEVATIONS SHOWN HEREON WERE ESTABLISHED FROM RECORDS AND EXISTING MONUMENTS FOUND IN THE FIELD, AND ARE TRUE AND CORRECT TO THE BEST OF MY KNOWLEDGE AND BELIEF. THIS SURVEY MEETS OR EXCEEDS THE MINIMUM STANDARDS OF GOVERNING AUTHORITIES.

[Signature]
 LICENSED PROFESSIONAL SURVEYOR
 DATE: 7-15-08



JOB NO. 00000	AS-BUILT SURVEY CLIFF VIEW TERRACE, 2411 BROWNSBORO ROAD	CARDINAL SURVEYING SERVICES, INC. 9009 PRESTON HWY LOUISVILLE, KY 40219 (502) 966-3446 FAX: (502) 968-7077 cardsurvey@insightbb.com	PROJECT DATA FILE NAME: CLIFF VIEW TERRACE DATE: 06-21-07 SCALE: 1" = 10' DRAWN BY: TY	SURVEYOR'S SEAL	REVISIONS																									
					<table border="1"> <thead> <tr> <th>NO.</th> <th>DATE</th> <th>DESCRIPTION</th> <th>BY</th> <th>TY</th> </tr> </thead> <tbody> <tr> <td>1</td> <td>2/28/08</td> <td>REVISED CLOSETS</td> <td></td> <td></td> </tr> <tr> <td> </td> <td> </td> <td> </td> <td> </td> <td> </td> </tr> <tr> <td> </td> <td> </td> <td> </td> <td> </td> <td> </td> </tr> <tr> <td> </td> <td> </td> <td> </td> <td> </td> <td> </td> </tr> <tr> <td> </td> <td> </td> <td> </td> <td> </td> <td> </td> </tr> </tbody> </table>	NO.	DATE	DESCRIPTION	BY	TY	1	2/28/08	REVISED CLOSETS																	
NO.	DATE	DESCRIPTION	BY	TY																										
1	2/28/08	REVISED CLOSETS																												
SHEET 4 OF 4	CLIFF VIEW TERRACE LLC ROGERS STREET FIREHOUSE 1122 ROGERS STREET LOUISVILLE, KY 40204																													

125 x 28