


E. L. MARGETTS & SONS, INC.

Off 97 Ward Street

Hingham, MA 02043

FAX: 740-5049

Telephone: 749-0559

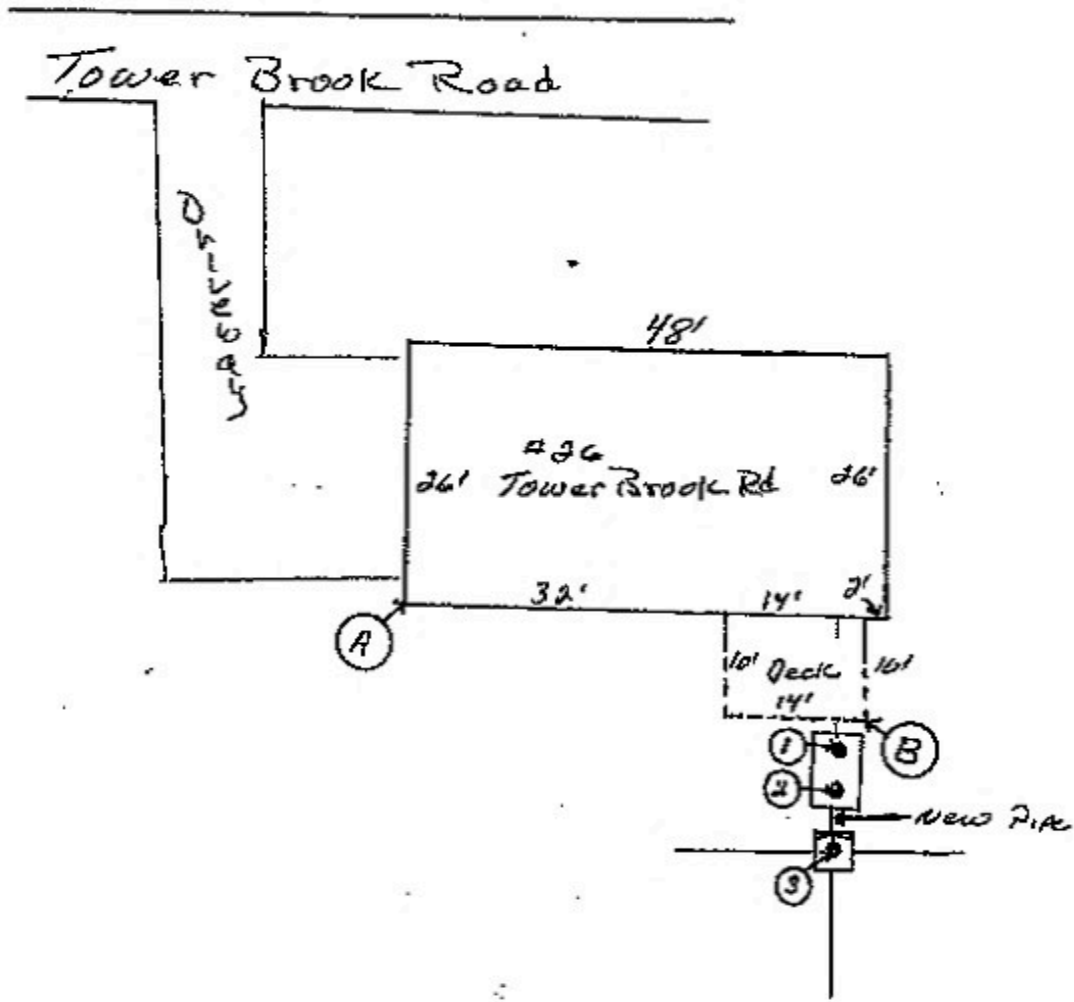

1-20 Scale	A	B
1 Tank inlet	45'	3.6'
2 Tank outlet	46.6'	8.6'
3 Distribution Box	49'	12.6'

AS BUILT 6-29-01  
Component Repair