


105' OF 2" PVC TRANSPORT PIPE
 SLEEVED IN SCH40 PVC UNDER ALL
 PARKING AND DRIVEWAY AREAS

6TH AVE

ORCHARD AVENUE

EXISTING
 WATER METER

2" UPGRADIENT PROPERTY
 LINE SETBACK

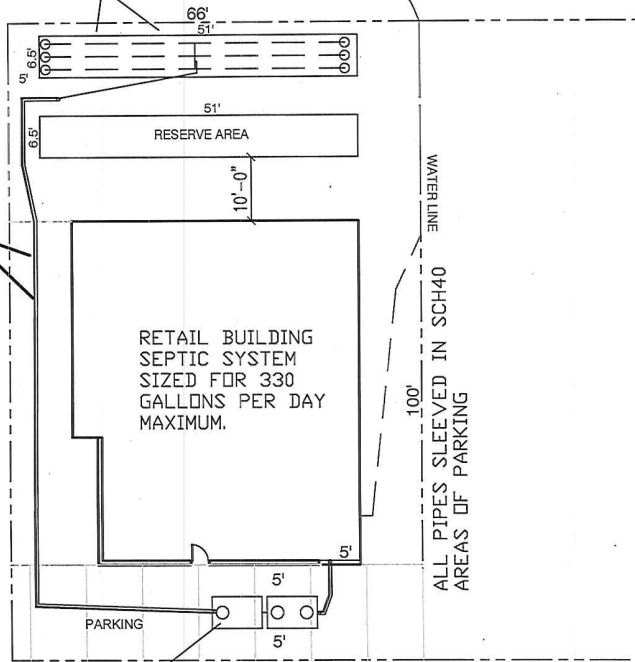

100'
 WATER LINE
 ALL PIPES SLEEVED IN SCH40
 AREAS OF PARKING

RETAIL BUILDING
 SEPTIC SYSTEM
 SIZED FOR 330
 GALLONS PER DAY
 MAXIMUM.

PARKING

CUZ CONCRETE W.T. H2O TRAFFIC
 RATED 1000/2 SEPTIC TANK

CUZ CONCRETE W.T. H2O TRAFFIC RATED
 1000 GALLON PUMP TANK WITH HYDROMATIC SP40
 EFFLUENT PUMP SET TO DOSE 18.3 GALLONS
 ONCE EVERY 80 MINUTES VIA CONTROL BY A
 RHOMBUS IFS TIMER CONTROL PANEL



Amman Septic Designs, Inc.

14525 246th Dr. SE
 Monroe, WA 98272
 AS-BUILT WWW.GOTPERK.COM

SCALE 1"=20'

Tax
 Parcel #:004576-005-001-00

(360) 794-7809 Office
 (425) 501-5195 Cell
 (360) 794-5408 Fax