
AS BUILT PLAN

IN

HINGHAM, MASSACHUSETTS

141 WOMPATUCK ROAD

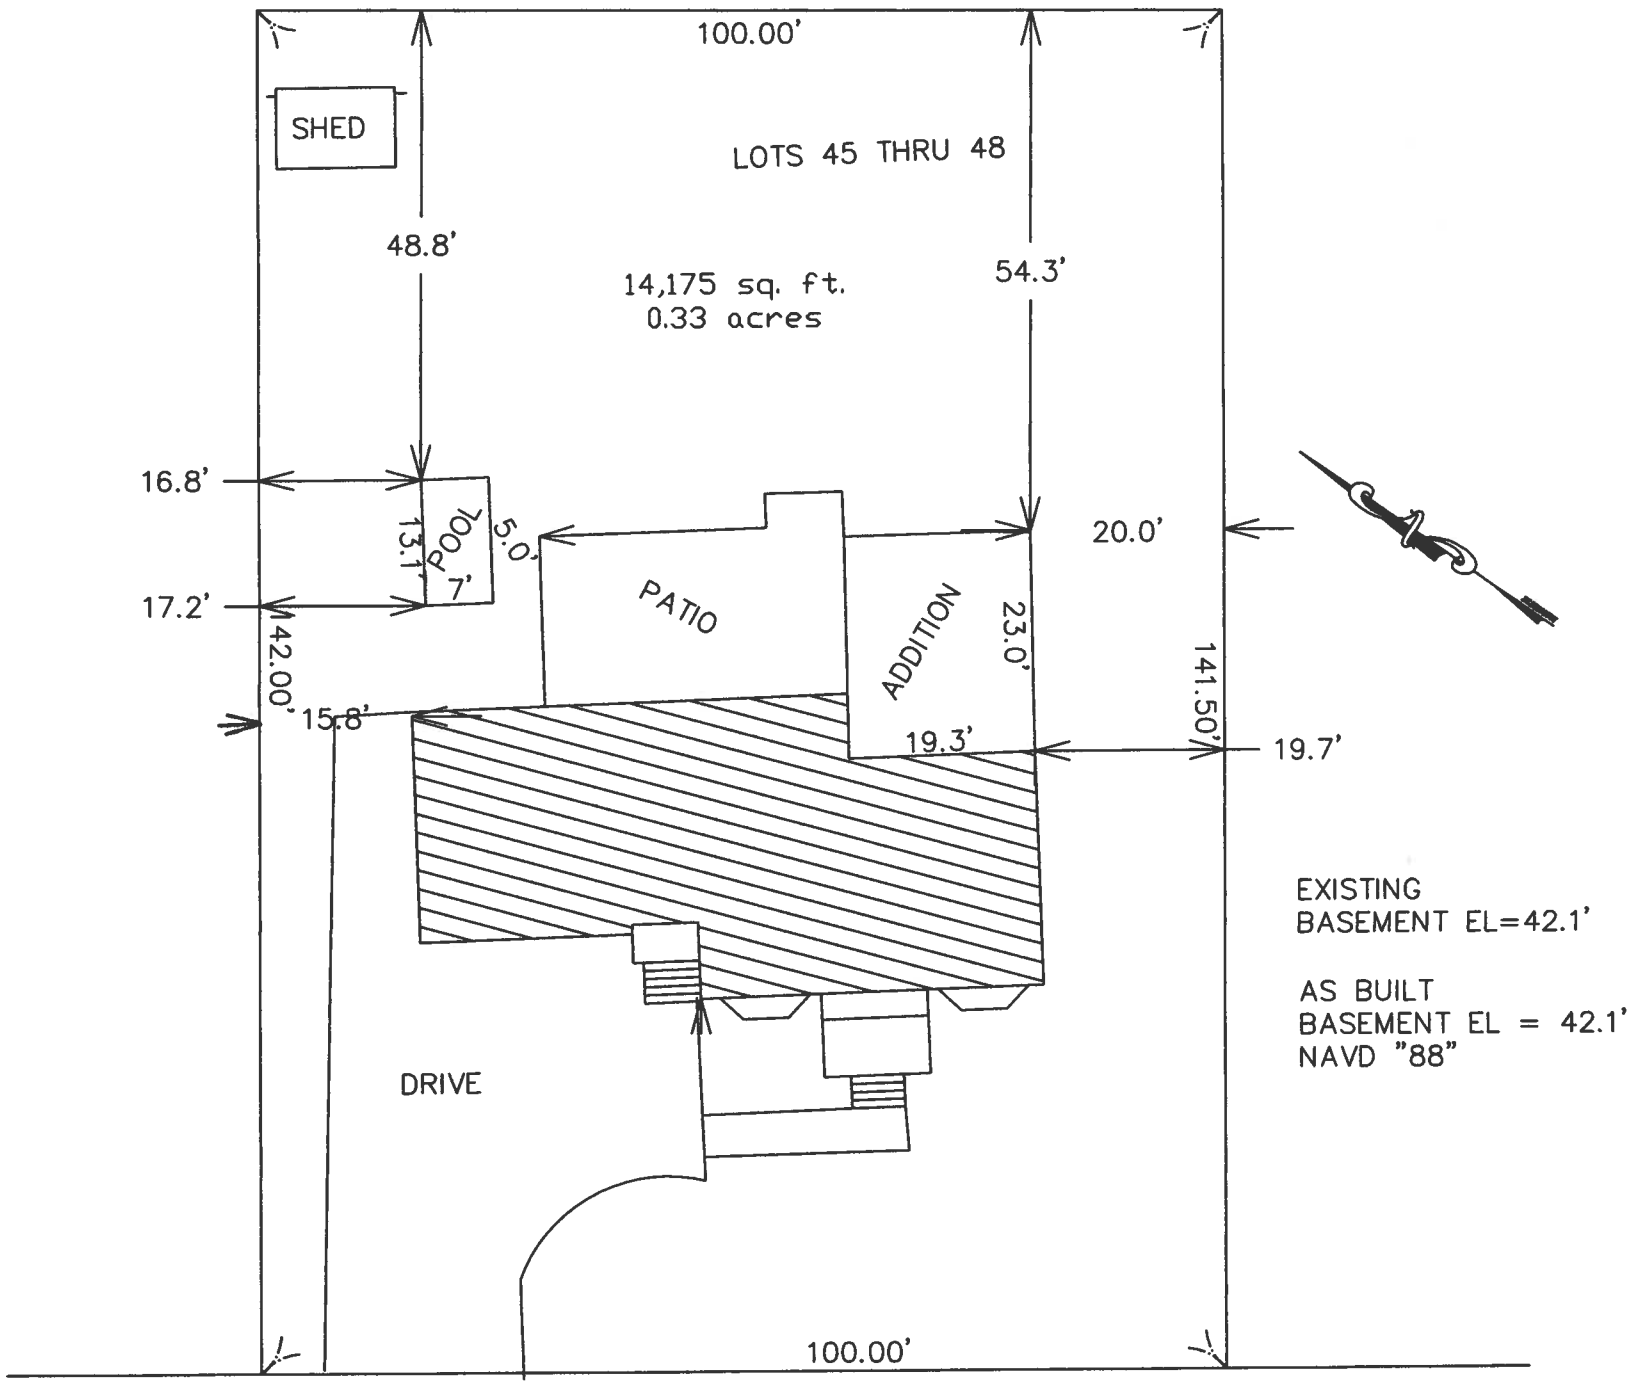

WOMPATUCK ROAD

GRAPHIC SCALE

20 0 10 20 40 80

(IN FEET)

1 inch = 20 ft.

COMMONWEALTH OF MASSACHUSETTS
CHRISTOPHER S. KELLEY
No. 37050
PROFESSIONAL LAND SURVEYOR

10-24-24

C.S.KELLEY LAND SURVEYORS
25 CENTER STREET
PEMBROKE MA. 02359
781-294-4454